


Ave.

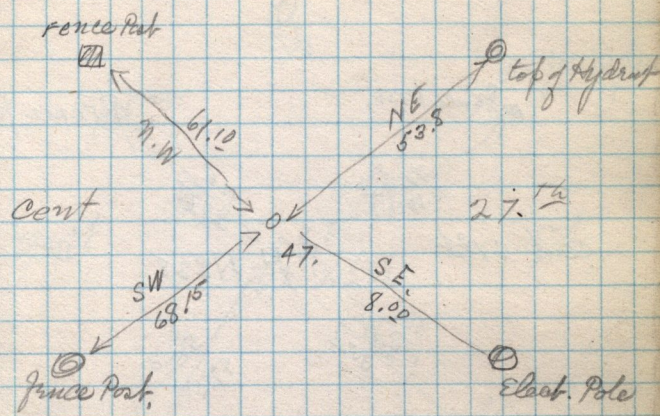

JEFFERSON

1