


Ave.

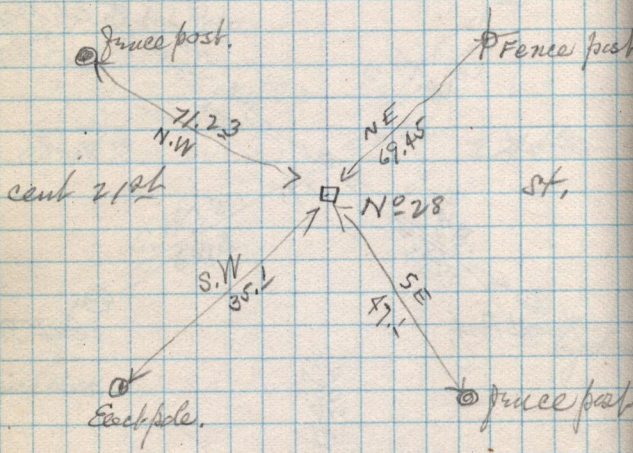

Macleodson

└