


Avenue

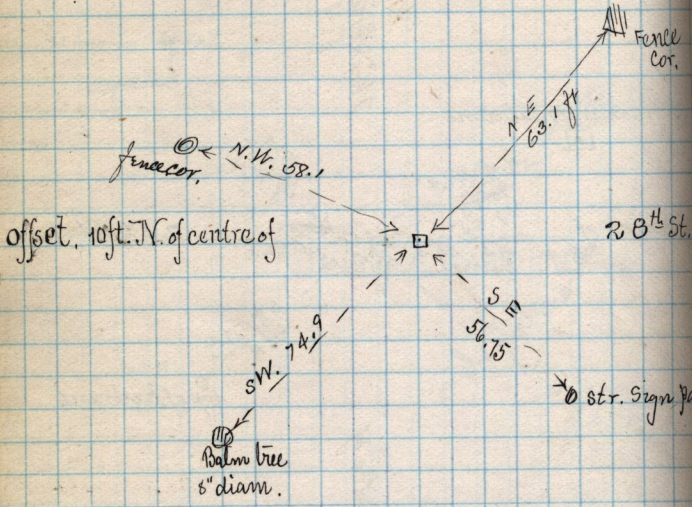

centre of Wall