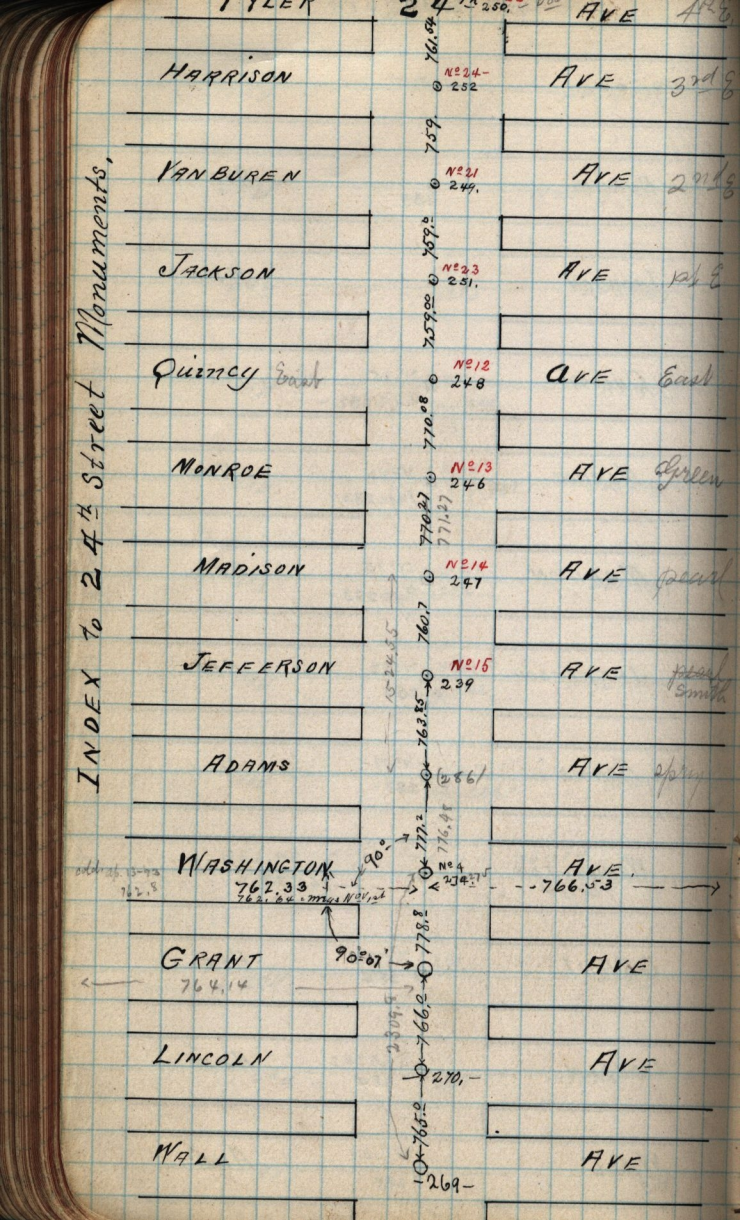
INDEX to 24th Street Monuments.
TYLER
HARRISON
VAN BUREN
JACKSON
Quincy
MONROE
MADISON
JEFFERSON
ADAMS
WASHINGTON
GRANT
LINCOLN
WALL
AVE
No 24 - 252
No 21 249.
No 23 251.
No 12 248
No 13 246
No 14 247
No 15 239
No 4
761.33
764.14
766.5
766.2
765.2
