


Book  
F  
9. Sec. Cons

Indexed

1

33

34

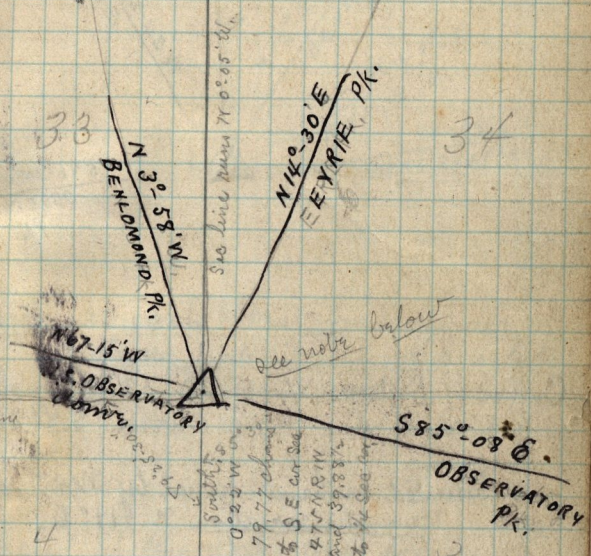

See line

See note below

4

3

Redwood stake 2" x 2" marked.  
 Corner of Sections 3-4-33 and 34  
 in Township Five and 6 North Range  
 one west - Salt Lake Meridian  
 Witness corner - a large flat boulder  
 N 43-57' E 1.62 chains

The true bearing to Obs. Pt. as per  
 U.S. Geological Survey = S 84° 29' E, which  
 makes the See line bearing South to bear S 10° 1' W