


2

32

33

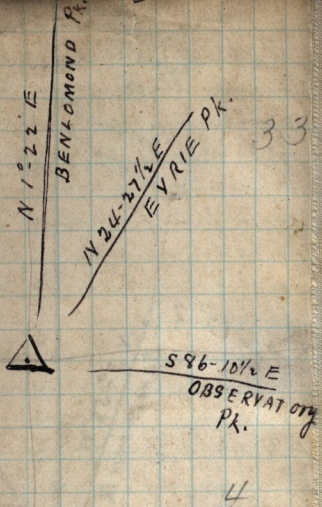

Corner of Sections 4-5-32-33 Township
five and six N. R 1 West. S.L.M.

Situated in land owned by Mr. Wood
1884. Magnetic variation N. 17° E.