


4

16

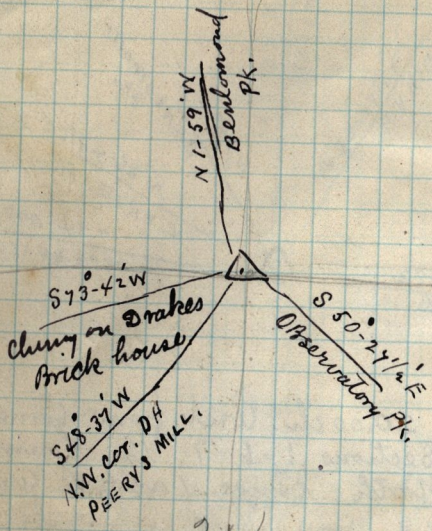

211

Corner. T. W. cor. NE 1/4 Section
21 - T 6 N R 1 W.

Situated in Mound Port district on
the line between lands owned
by D. Moore and Drake.