


25

30

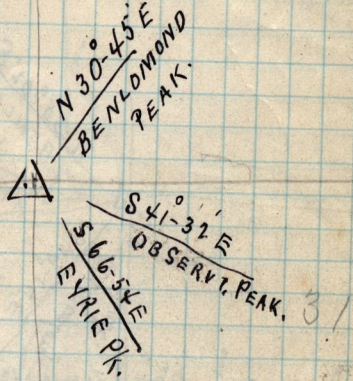

36

Corners. Sections 30-31-25-36
 T 7 N. Ranges one & two
 west of Salt Lake Meridian