


6

30

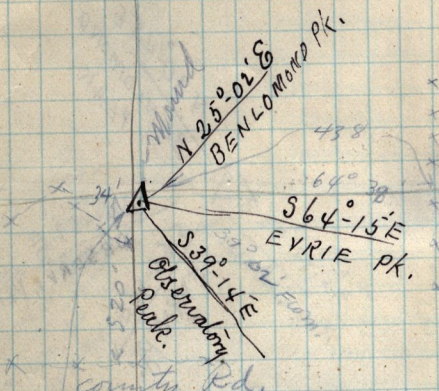

Corner.

N.E. cor. N.W. 1/4 SEC 31  
T. 7 N. R. 1 W. Weber County.

2708

31

