


21

22

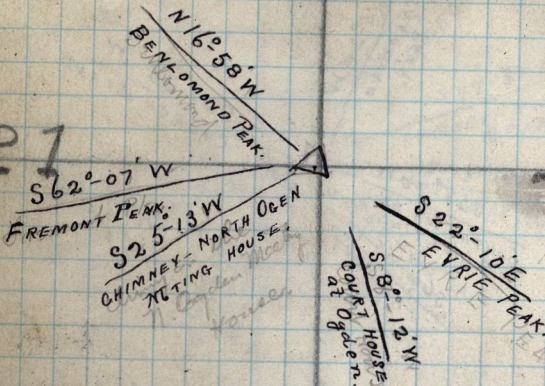

Corner N & E. cor. S.E. 1/4 SEC 21
 T. 7 N. R. 1 W. Situated North East
 from North Ogden.
 Weber County

2 / East line of Sec 21 bears
 N. 0°-10' W.