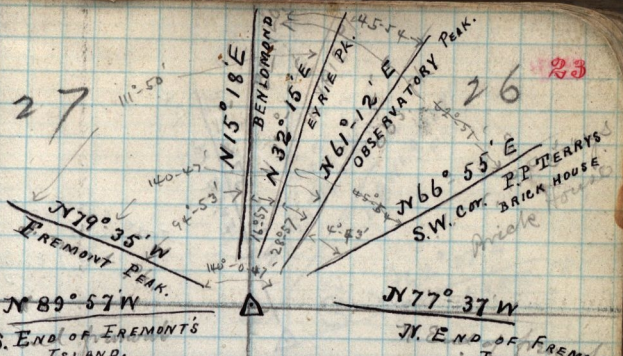

Corner of Sections 26-27-34-35
T 5 N R 2 W

DAVIS COUNTY.

Magnetic Variation N 16°-45' E March 31-1885 -

79-35
15-18
94-53

32-15
15-18
16-57

61-12
32-15
28-57

46-55
61-12
14-43

94-53
16-57
111-50
28-57
140-47

45-54
94-53
140-57
14-43
125-14

28-57
16-57
45-54
16-57
62-51
94-53
14-47