


28

25

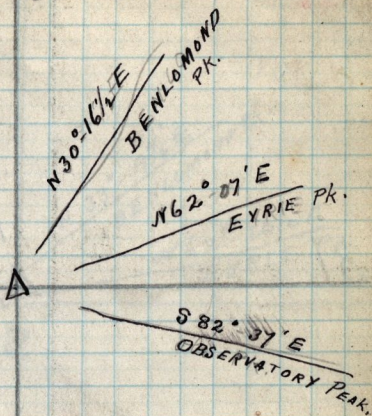

S. E. corner of S. W. $\frac{1}{4}$ Sec 28 T 6 N

R 2 W. Salt Lake Meridian

Utah County

April 25-1885.

Note: The South line of the above section
 runs East and West.

33