



✓
- Indexed. -

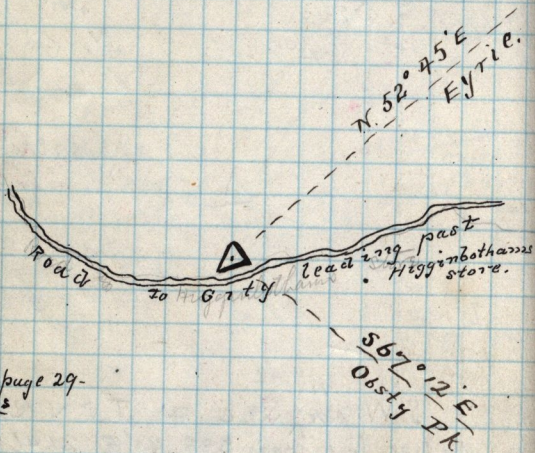

See book D-page 29-
Field notes

The above point is located 27.81
1142 South ²² 1.47
chains West from Center Sec 19 T 6 N R 1 W,

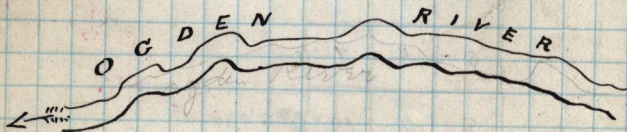

The above is a cedar post on the live City corporation
and was ran by order of City Council under direction
of W. Judson bearings according to Wheeler's report.
In Wilson's report.