70

May 7-1887

N.W 1/4 Sec 9 T 6 N R 1 W.

W 1/2 by Chresten Hjort

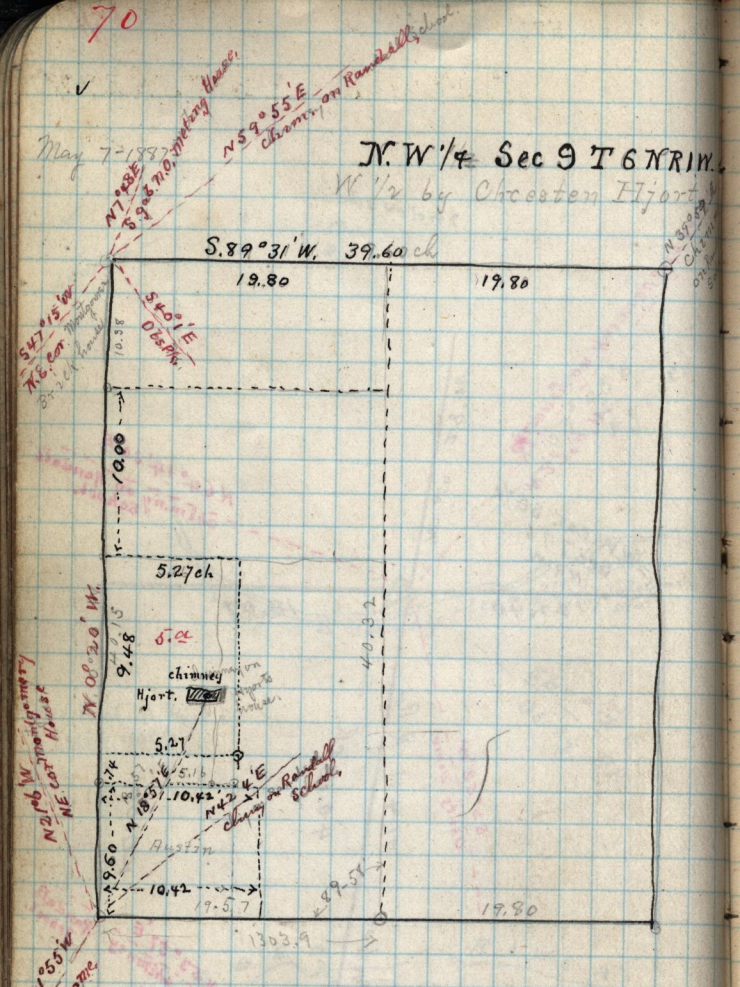

Copy of deed from John Austin to Claes A Bergzund dated Nov. 14-1884 - Recorded S-68 - Part of N.W 1/4 Sec. 9 T 6 N R 1 W. Beg. at S.W cor. E. 10.42 ch, N. 9.60 ch W 10.42 ch S 9.60 ch to beg. 10.0 with right of way from N.W cor. to Street.

4-2-04