


May 26-1887

71

S. W 1/4 Sec 23 T5NR2W

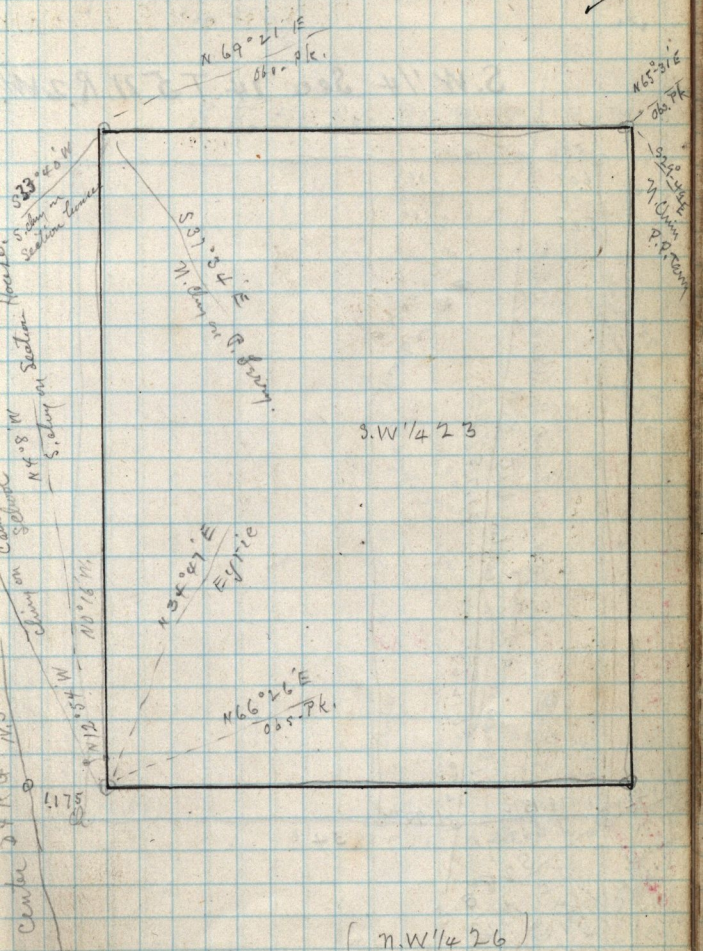

(N.W 1/4 26)

0	-	31	-	30
59		49		00
9		2		39
69				