N. W. 1/4 Sec 26
T. 5 N R. 1 W.

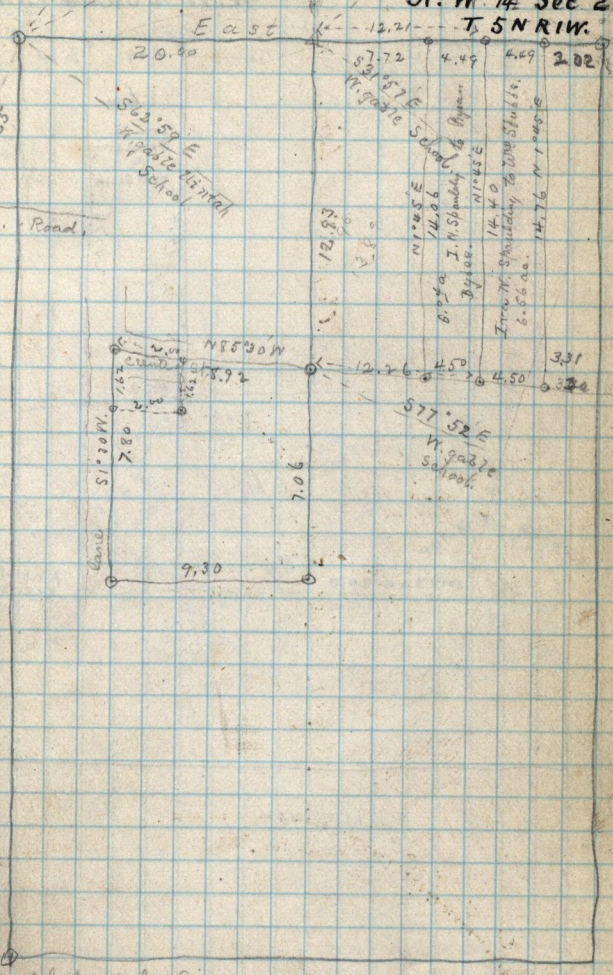

Goddard lacks 46 chs. to end

Running East to N.E. cor Sec. 26.
Straight line bears South of 1/4 sec cor. 66 ch. and of Sec. Cor. 40 ch. Hence 1/4 Sec. Cor. 46 ch. to Sec. Cor. makes angle to Sec. Cor. 02 17' North.