


June 7 - 1887 -

-Indexed-

81

S.W. 1/4 Sec. 22 T6 N.R. 1W

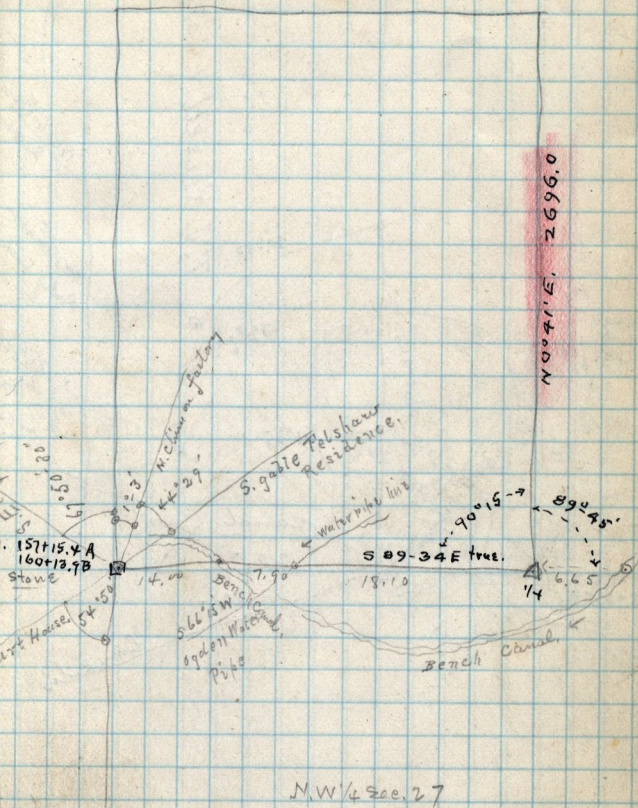

45-32	40.
1-3	11.90
44-29	18.10