S.W. 1/4 Sec 23 - T6NR1W

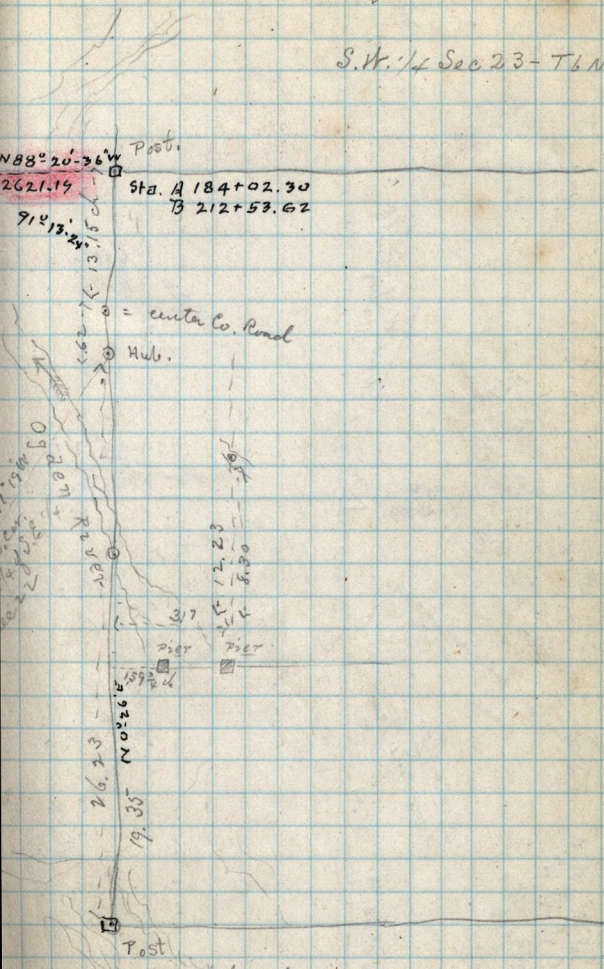


in small Ravine
on steep hill side

40
26.23
13.77