

9.0 July 2-1897-


F. A. Miller - Patentee.



18.45 ch. to
Mrs. Cantle of
Cedar Mountain etc.

SE 1/4 Sec 17
T6N R1W.

11.10

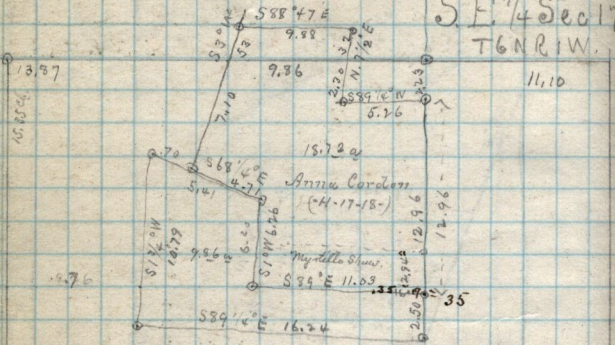

13.37

15.85 ch.

S 88° 47' E

9.88

9.36

S 89° 14' E

7.10

N 77° 25' E

3.20

S 89° 14' N

5.26

15.72 ch.

S 68° 1/2° E

5.14

4.21

Anna Cordem
(-H-17-18-)

Myrtle Shaws.

S 89° E 11.03

S 71° 1/2° E

6.20

9.26

S 89° 14' E

16.24

12.96

12.96

2.50

35

2.76