93
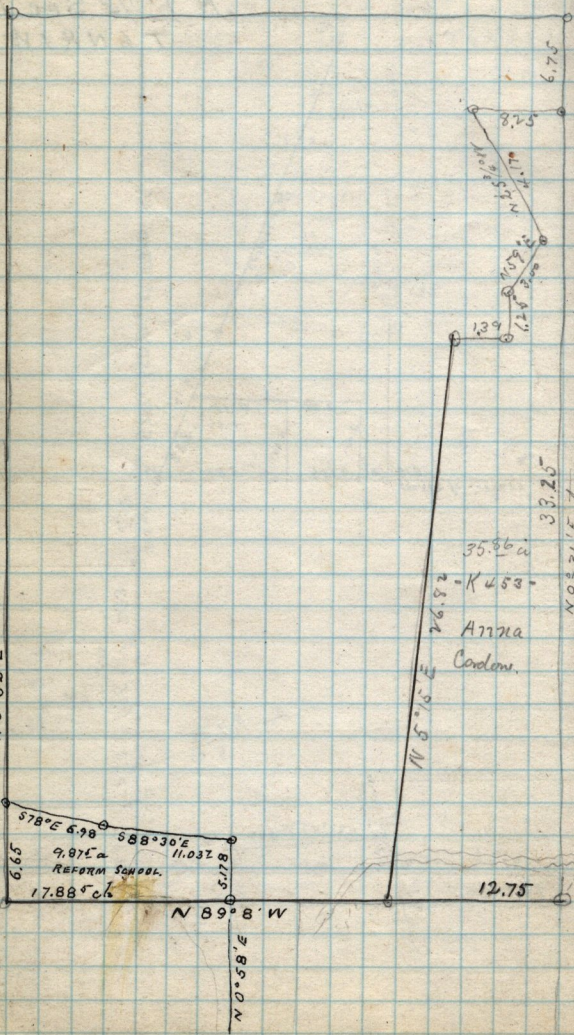
LORIN Farr Patentee S.E. 1/4 Sec 21 T6N R1W