


9-1887-

SW 1/4 Sec 16 T6 N-R 1 W.

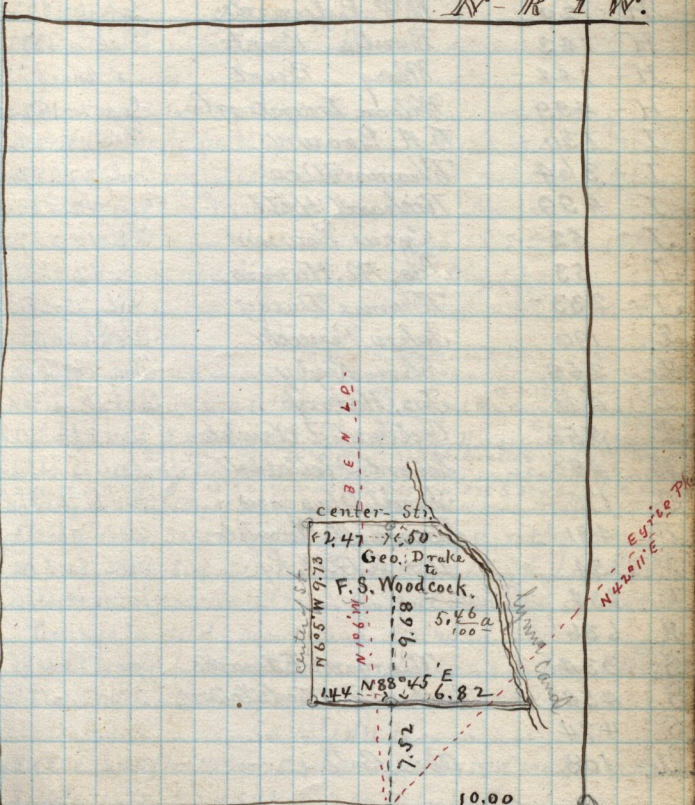

center-Str

2.47

7.50

N 65° W 9.73

N 10° W 9.68

9.68

5.46 a

100

N 88° 45' E

6.82

7.52

55° 20' 30" E

5.16 55' E

on Drake's house

S.E. cor. Sec 16 T6 N-R 1 W