


S. W. 1/4 Sec ~~E5~~ T6 N.R. 2 W.

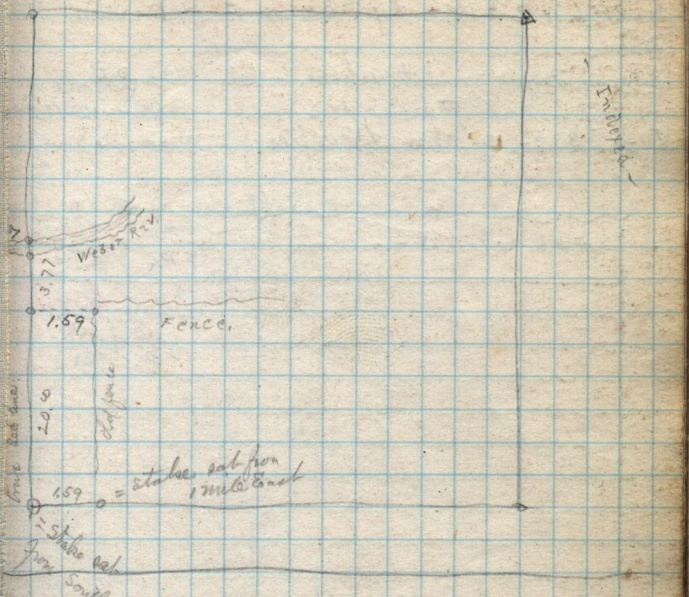

Descriptions

161 ch W. SE. cor. N 1 3/4 W. 13.25 N 89 1/4 W. 16.41 S 5 1/2 E 8.60 to Riv. at gate of P.C. canal, up Riv
 on line E. 12.50 to top, 20.14 a

161 ch W. from SE. cor N 1 3/4 W 13.25 W 5.00 S 13.25 E 5.00 to top 7.0

v