120



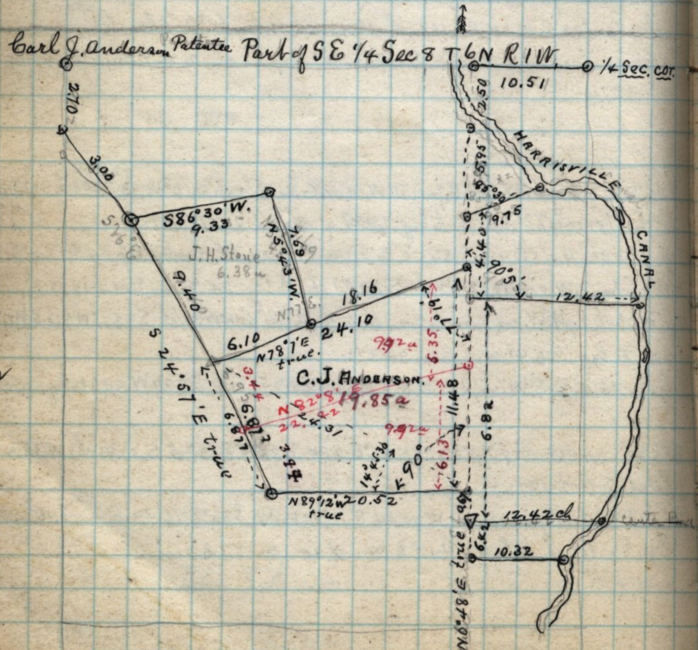
Carl J. Anderson Patentee Part of S E 1/4 Sec 8 T 6N R1W