123

S. E. 1/4 Sec 5 T 6 N. R 2 W

Feb 22 - 1888.
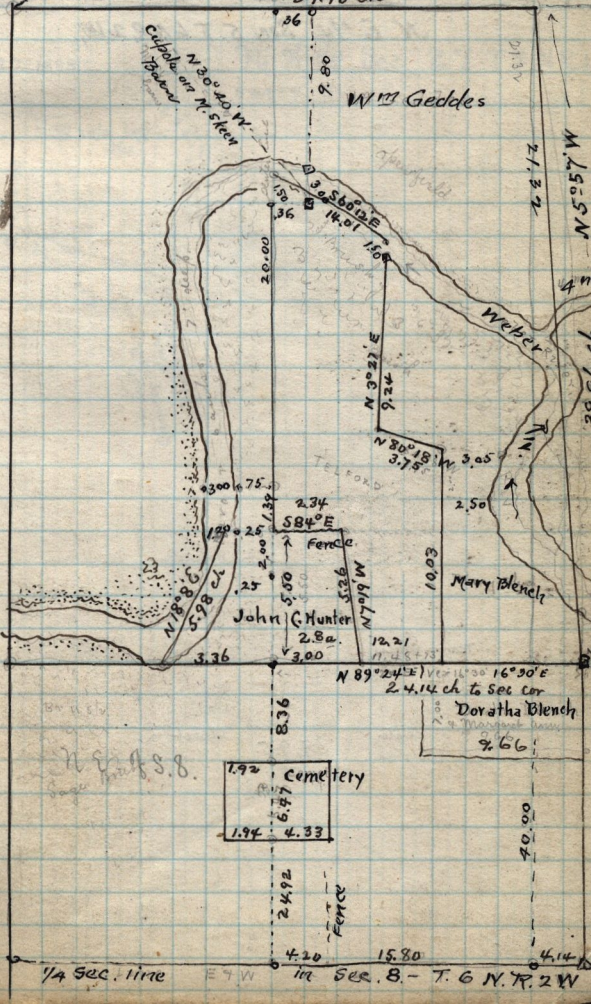
John Dreaney Patentee S.E.1/4 Sec 5 T 6 N R 2 W
Dated 30-Dec. 1884 Homestead Certificate 2352
Recorded in Book R, page 612
Recorded Feb 24-1885