

176

✓ S. W. 1/4 Sec 33 T7N R1W,
John Orton Patentee.

K-598


(heirs) Alfred Barrett

Dec 10-1877

✓ S. E. 1/4 Sec. 25 T6N R. 2W,

March 7-1883

J. R. Pool Patentee

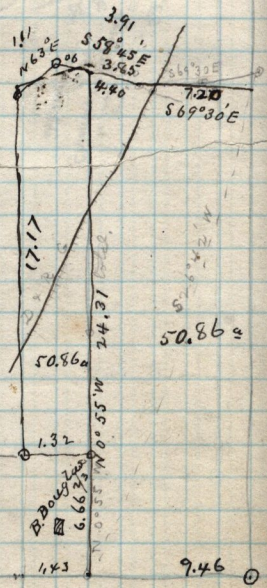

See field Book A. page 49, for deed from
Ivanosoff to Snider