

- See map -

N. W. 1/4 on page 170.








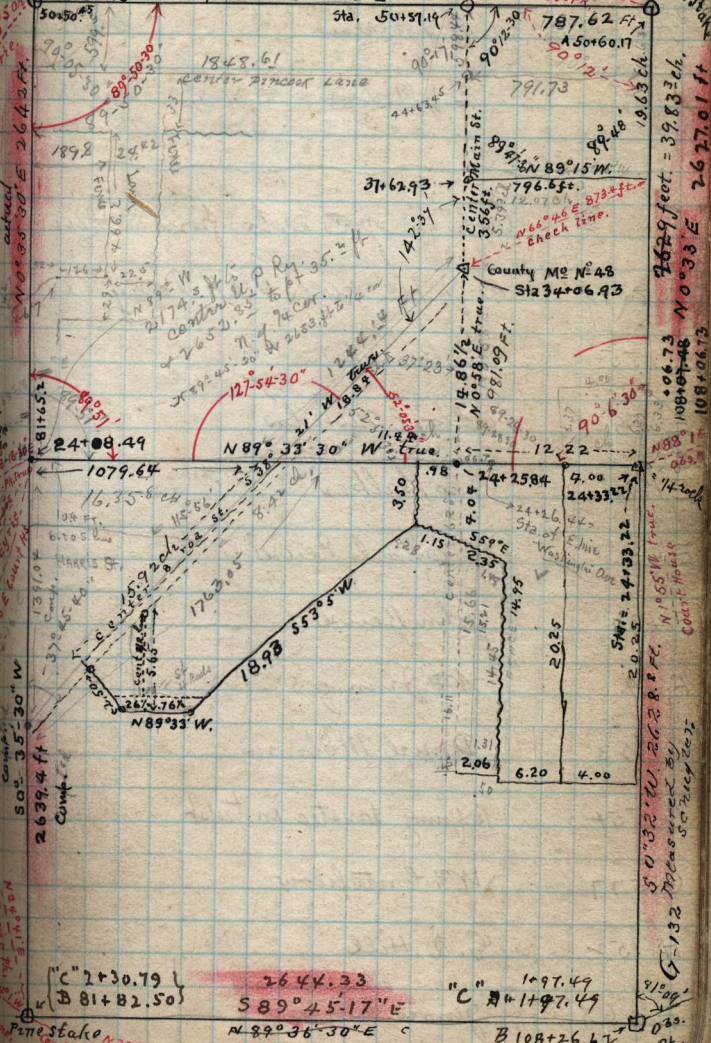

actual  
81+65.2  
1079.64  
24+08.49  
2639.4 ft  
50° 35' 30" W  
Comp. 2639.4 ft

7629 feet = 39.83± ch.  
N 0° 33' E 2627.01 ft  
108±67.48  
N 0° 32' W 2628.8 ft.  
G-132 Measured by  
51° 09' Obs. pk.

"C" 2+30.79	2644.33	"C" 1+97.49
"B" 81+82.50	S 89° 45' 17" E	"C" 11+97.49
Pine Stake	N 89° 36' 30" E	B 108+26.62

26 1/2 links to West side st + 76 1/2 links to E. side st  
Street 4 Rods wide