N R 2 W. Recorded in Book G 198 - & S ½ NE ¼ 12 - T 5 N 3 W.

Descriptions

Beg. NW. cor. NW ¼ 18 T 5 2 W. - E. 19.00 S 5.43 ch, N 89 ¾° W. 19.00 N. 5.35 to beg.
of NE ¼ 12 T 5 N 3 W, Beg 18.00 E. SW. cor. - N. 6.20 E 20.55 S. 6.20 W. 20.55 12.74 a
NE ¼ 12 - T 5 N 3 W. Beg. SW. cor. N. 6.20 E. 18.00 S. 6.20 W 18.00 to beg 12.16 a
Lot 5 - Block 16 - Plat - "a" Hooper City Survey. 1 ¼ a.
NE ¼ 12 T 5 N 3 W. Beg. 6.20 N. S.W. cor. N 13.80 E 38.55 S 13.80 W 38.55 5.3 2/10 a
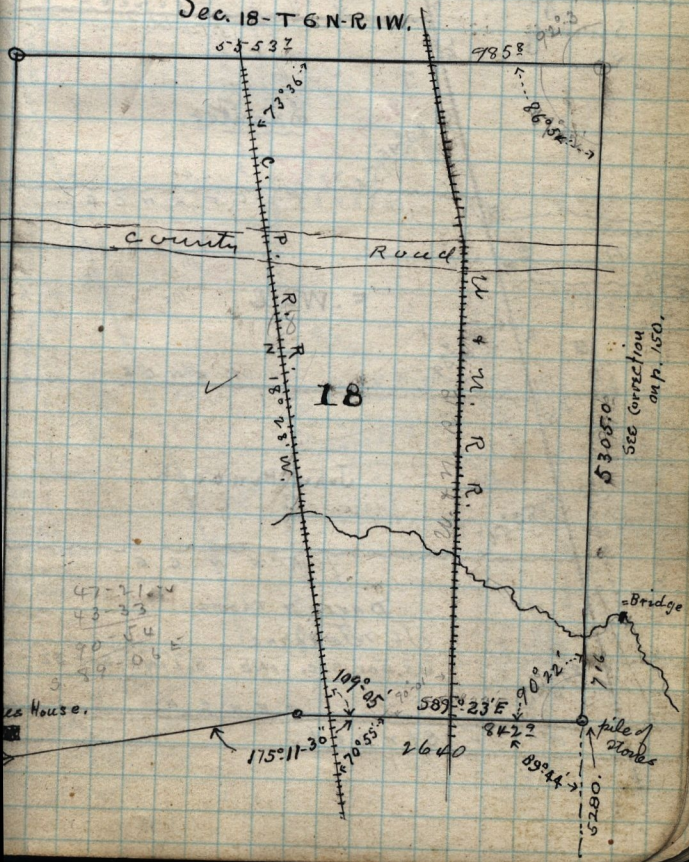
Sec. 18 - T 6 N - R 1 W.