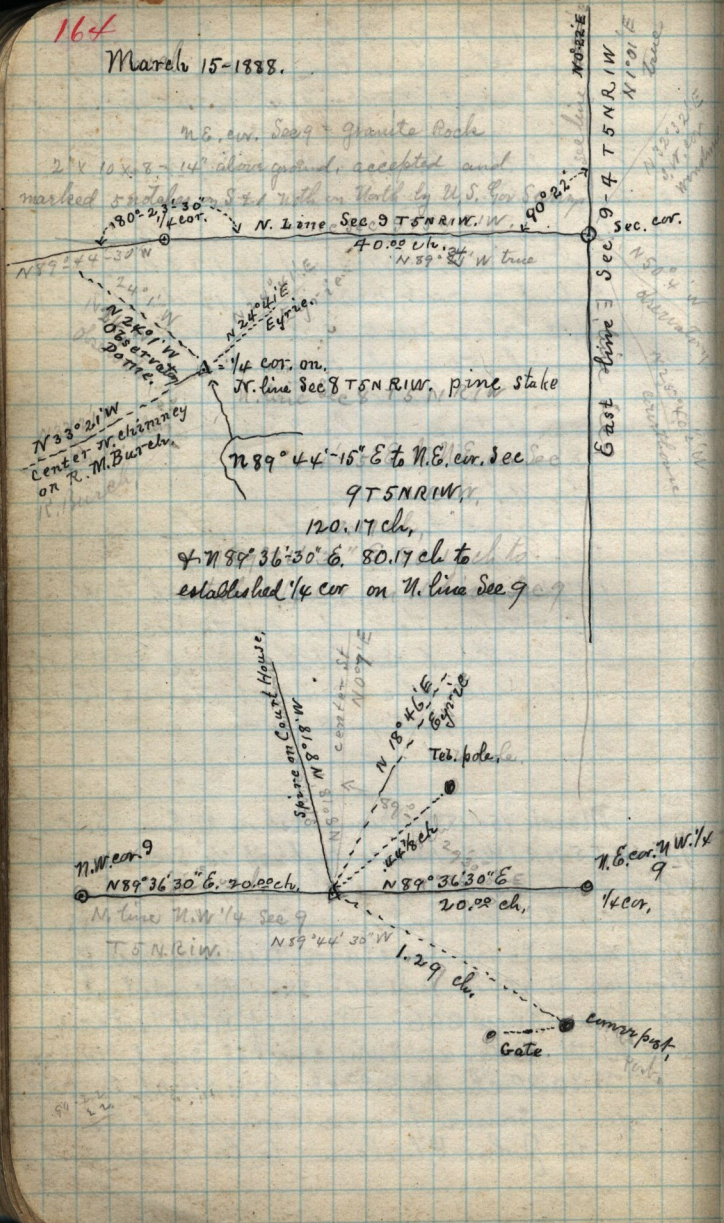March 15-1888.