May 9-1888-

Sec. No 6 T 6 North R 2 W.

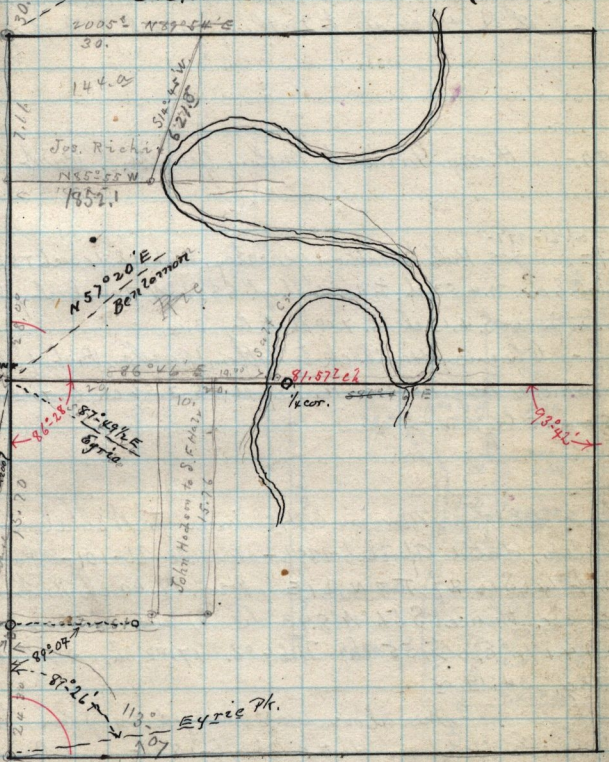

See O-p. 143

see Field Book B-184