


180

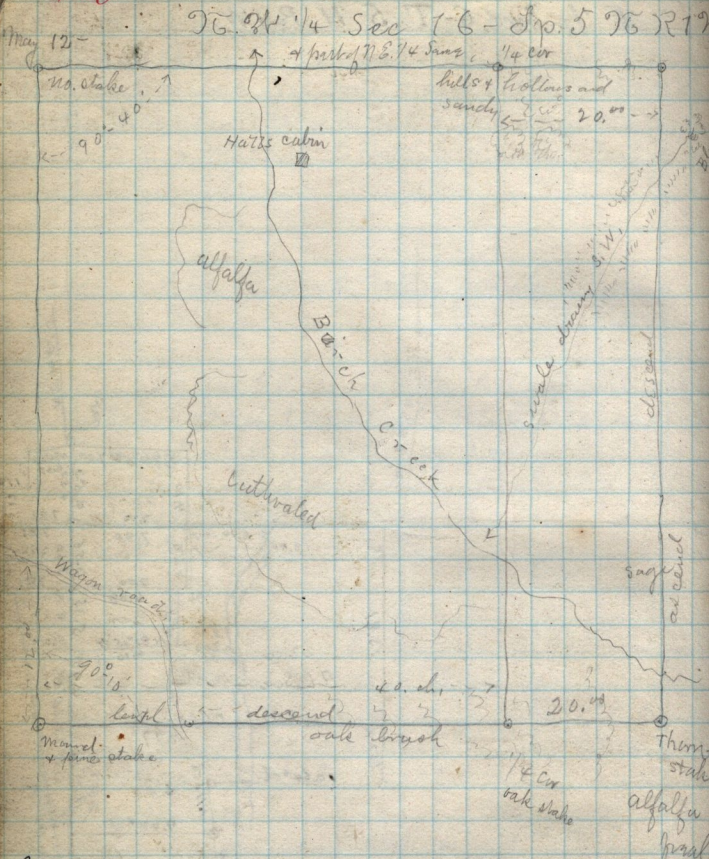

Copy. deed, W.H. Wright to John Brazier - May 24 - 1887 - Recorded W 295-375 - Part. N.W. 1/4 Sec 4 T5 N R1 W. Beg. 5. ch W. of S.E. cor. said 1/4 Sec, N10.37' ch, W. 7.75 ch, S10.37' ch, E 7.75 ch, to beg. 8. ac ⊕

Copy. deed, from Alfred Stanford to John Brazier - May 19 - 1886 - Rec'd U-415 - Pt. N.E. & N.W. 1/4 Sec 4 T5 N R1 W. Beg. 16.90 ch. N. of S.E. cor. N.W. 1/4 said Sec, W. 5.00 ch, N13.30 ch, E 6.00 ch, S13.30 ch, W 1.00 ch to beg. Also Beg. 9.85 ch. S. of N.E. cor. said 1/4 Sec, and 5.00 ch, W. Thence W. 7.72 ch S 13.30 ch. E 7.72 ch, N13.30 ch to beg. ⊕

Copy. deed, Thos. R. JENKINS, to John Brazier, - June 14 - 1887 - W-45 - Part N.W. 1/4 Sec 4 T5 N R1 W. Beg. 10.20 ch N.S.E. cor. oak 1/4 Sec W 5.00 N 6.70 ch E 5.00 S 6.