May 16-1888-

W ½ Sec 27-T 7 N R 1 E

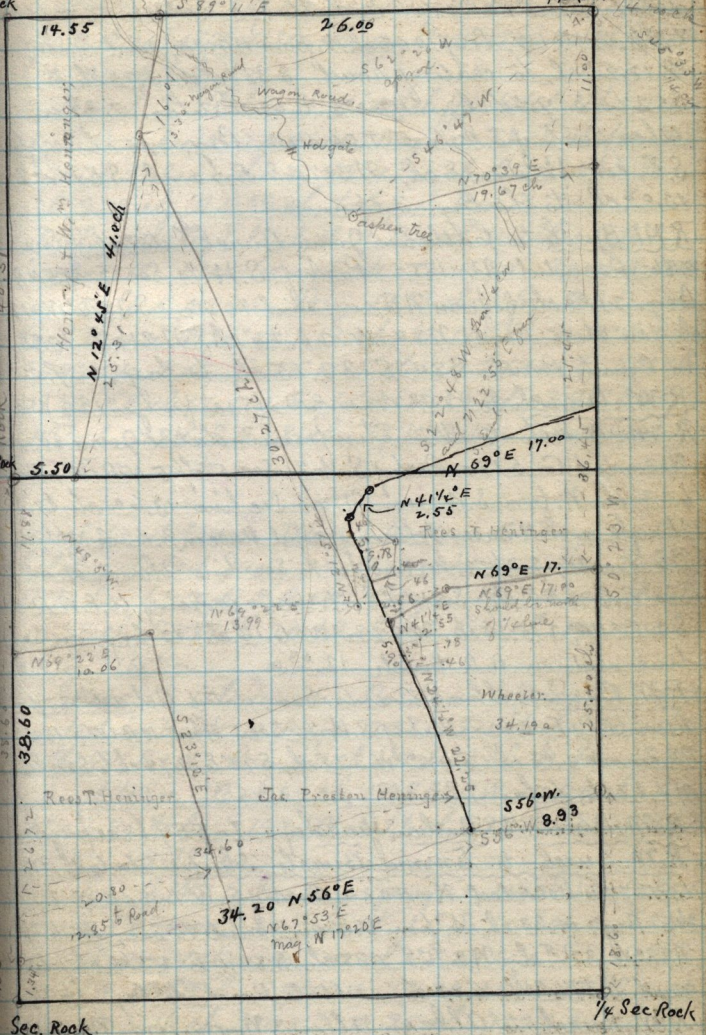

N 24½° W 17.17 to H. C. Heninger S. line and 22.71 ch to line wheeler & H. C. Heninger. The line designated N 41¼° E is 5.36 ch mag. about to meet the line coming up from South.