


May 30 - 1888 -

187

U.P.R.R Co to Walter Lindsay - May 11-1883  
for  $N\frac{1}{2}$  of S.W.  $\frac{1}{4}$  Sec 21 - T7N R1E, 80-a  
Recorded T-227-

U.S. Patent to Walter Lindsay, June 20-1883  
 $N\frac{1}{2}$  NE  $\frac{1}{4}$  Sec 20 T7N R1E, 80-a cross  
Recorded T-page 226-

(fraudulent entry  
no dwelling name)

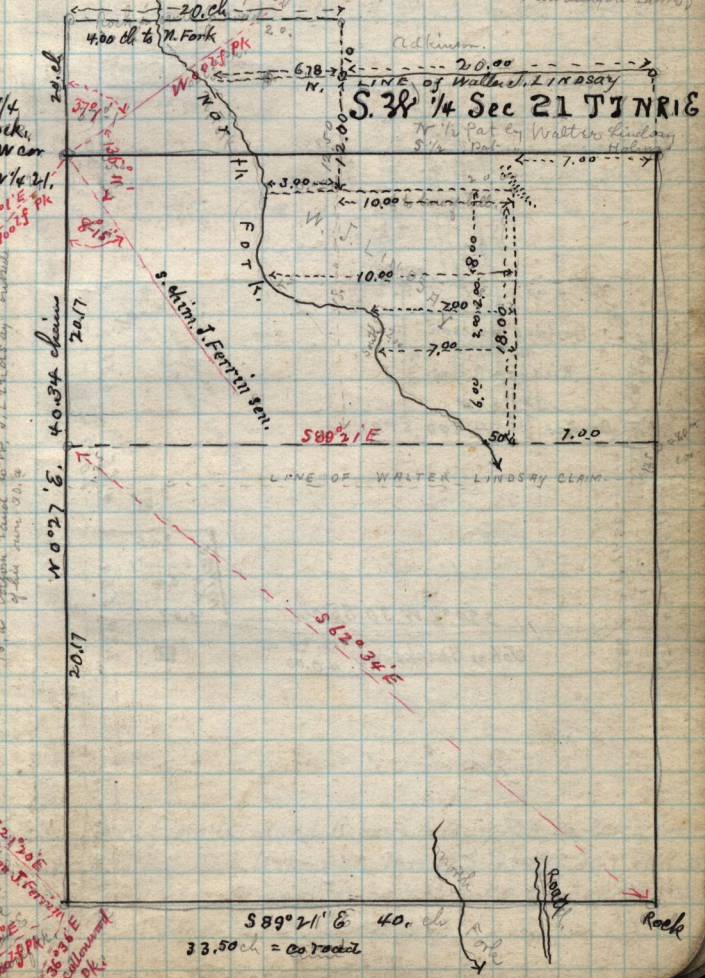

1/4  
cks,  
W cor  
1/4 21,  
1 E PK  
00015 PK  
of this same 30.3

$S 21^{\circ} 30' E$   
 $S 89^{\circ} 21' E$   
 $S 89^{\circ} 21' E$   
 $S 89^{\circ} 21' E$   
callous  
PK