


196

H-Bowns Patentee. ✓

Surv. July 27-1888.

S. E 1/4 Sec. 11-T6N.

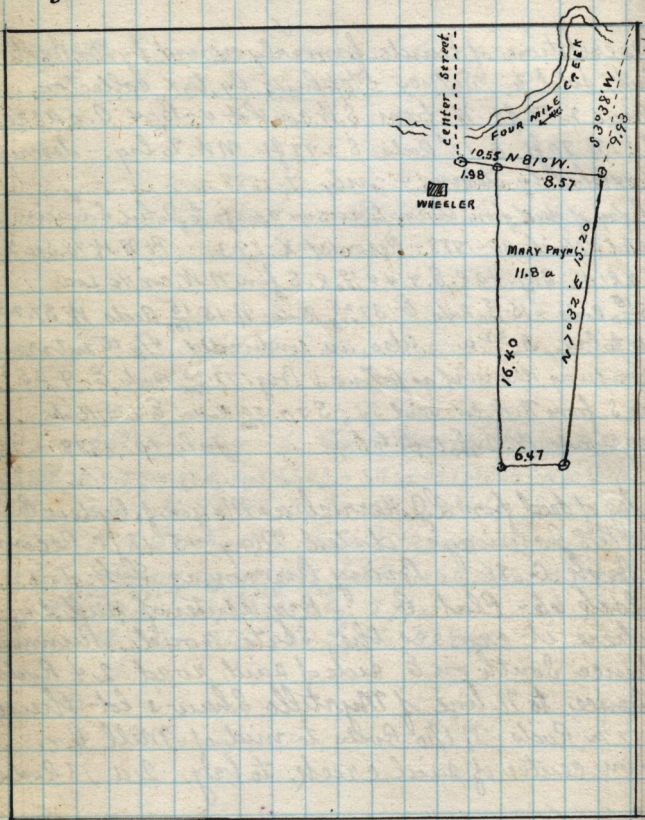

✓  
 Copy of deed from Andrew P. Lufgreen to Andrew-Rentz  
 dated July 21-1879 - Part of N.W. 1/4 Sec 8-T6N R2E  
 Beg. S. 47 ch N. from S.W. cor. said 1/4 Sec. E. 71.05 ch N 11° 0' W  
 20.55 ch W. 6.50 ch S. 20.50 ch to beg. 13.89 a  
 Recorded-book P-107-