198

Copy. deed. from Nancy V. Murphy to John D. Fife dated May 1-1888 - Recorded Book X - 81, Part of N.W. 1/4 Sec. 21 T6 N R1W, Beg. 96 Rods South & 63 Rods East from N.W. cor 1/4 Sec, E. 16 Rods, N. 20 Rods W. 16 Rods S. 20 Rods to beg.

(See page 114)

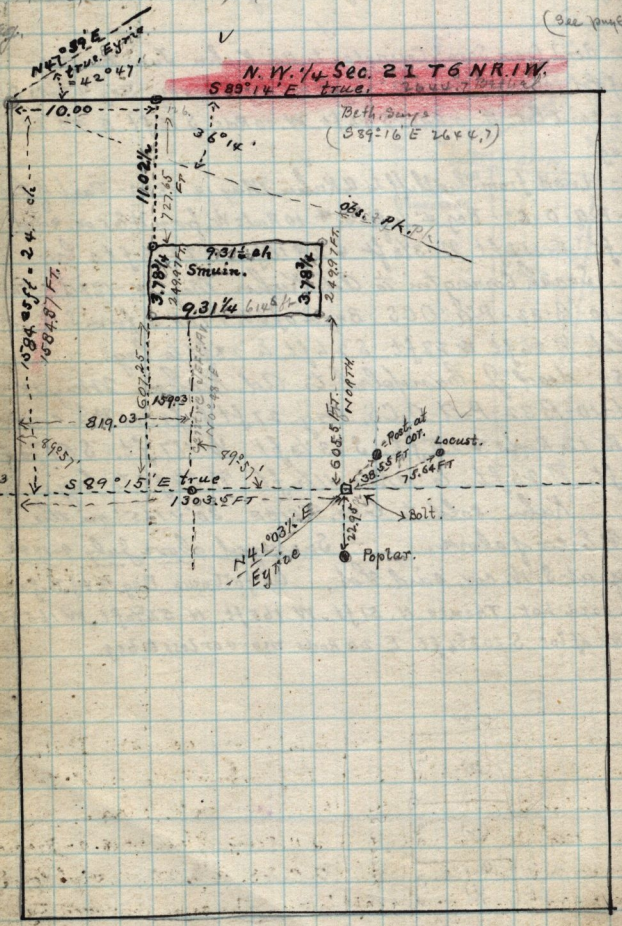

Rebecca Stayner. property on Main STR - Pt Lot 9 - Block 25 Plat "A" Beg. 26 ft N. from S.E. cor. Lot 9 - N. 30 ft W 165 ft S 30 ft E. 165 ft to beg.