


Aug 2-1888 -

Note a nail, marks the center of main St at 1604.9 ft N. from W.C.S.M.T No 3 -

199

N.E. 1/4 Sec. 20 T.6 N. R.17 W.

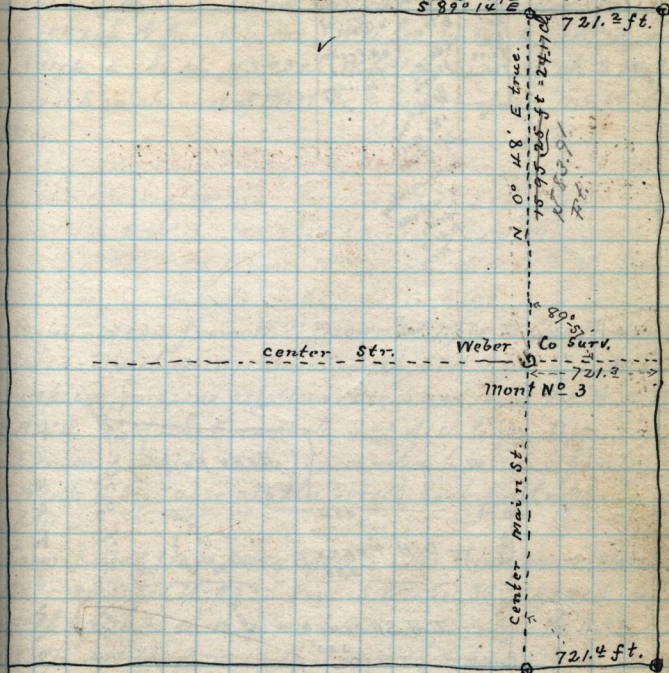

Copy deed - Johnathan Browning to D.H. Peery. Recorded I-517 - Pt of lots 7-8-B-25-Plat "a" O-C-S. Beg. 2.4 ft E. from N.W. cor. lot 7 - S 8 Rods W 2.4 ft, S 8 Rods, E. 70 1/2 ft, N 16 Rods W 4 6 1/2 ft, to beg.

Copy - Deed from Ogden City to D.H. Peery. June 4-1870 - Recorded Book E-160 - Pt lot 9-B-25-Plat "a" O-C-S. Beg. N.E. cor. said lot, S 76 ft, W. 330 ft N 76 ft E 330 ft to beg. The same conveyed by John W. Browning to Peery Sept 30-1867 - & recorded Book D page

Copy of deed from Johnathan Browning to Geo. Whitehead Feb 4-1874 - Recorded I-334 - Pt Lot 7-B-25-P "a" - Beg. N.W. cor. said Lot. 2.4 ft S 8 Rods W 2.4 ft, N. 8 Rods to beg.