



FOURTH STR 309 1/2 ft

INDEXED to here

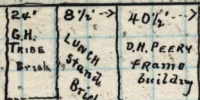

the West 2ft of this being considered as surplus land, to go to Peery.

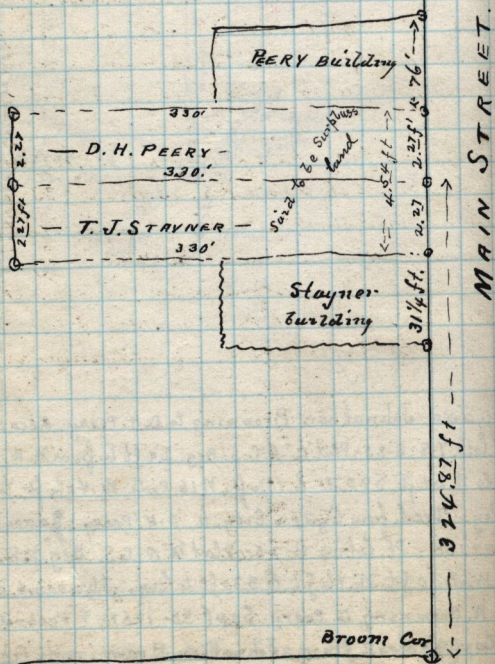

- Aug 2nd 1888 -

FIFTH STREET