202

Aug. 12-1858-
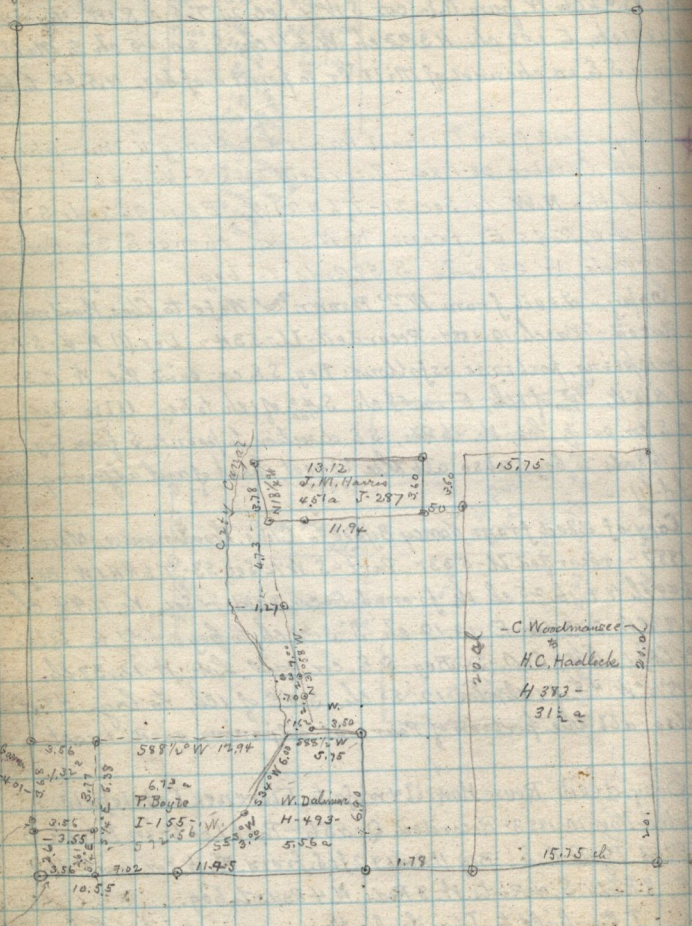
S.W. 1/4 Sec. 33 T 6 N R 1 W.