Sep. 19 - 1888 -
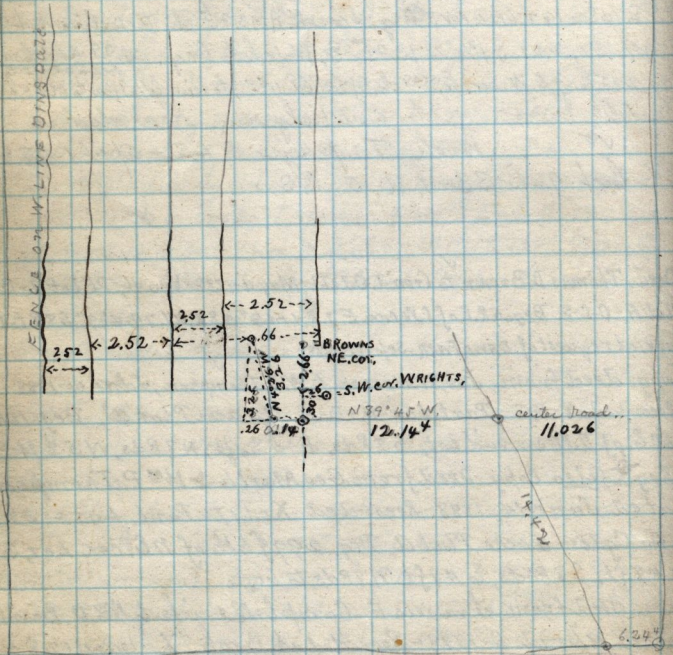
S.E¼ Sec. 19. T 6. N R 1 W,