✓

Sec. 14 T 6 N R 1 E  Oct 25-1888

1888

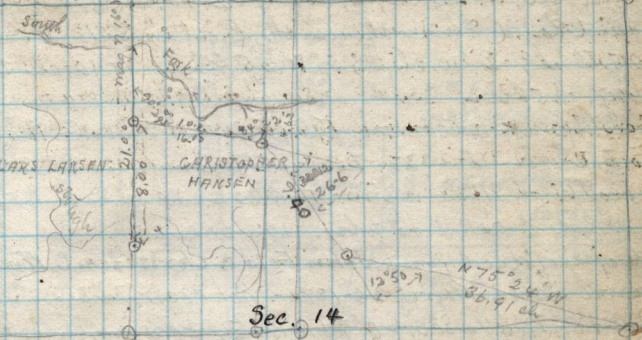


N.W. 1/4 of N.W. 1/4 Sec. 15 - T 6 N R 2 E, to be conveyed by Hammond & Geertsen to Nathan Slater