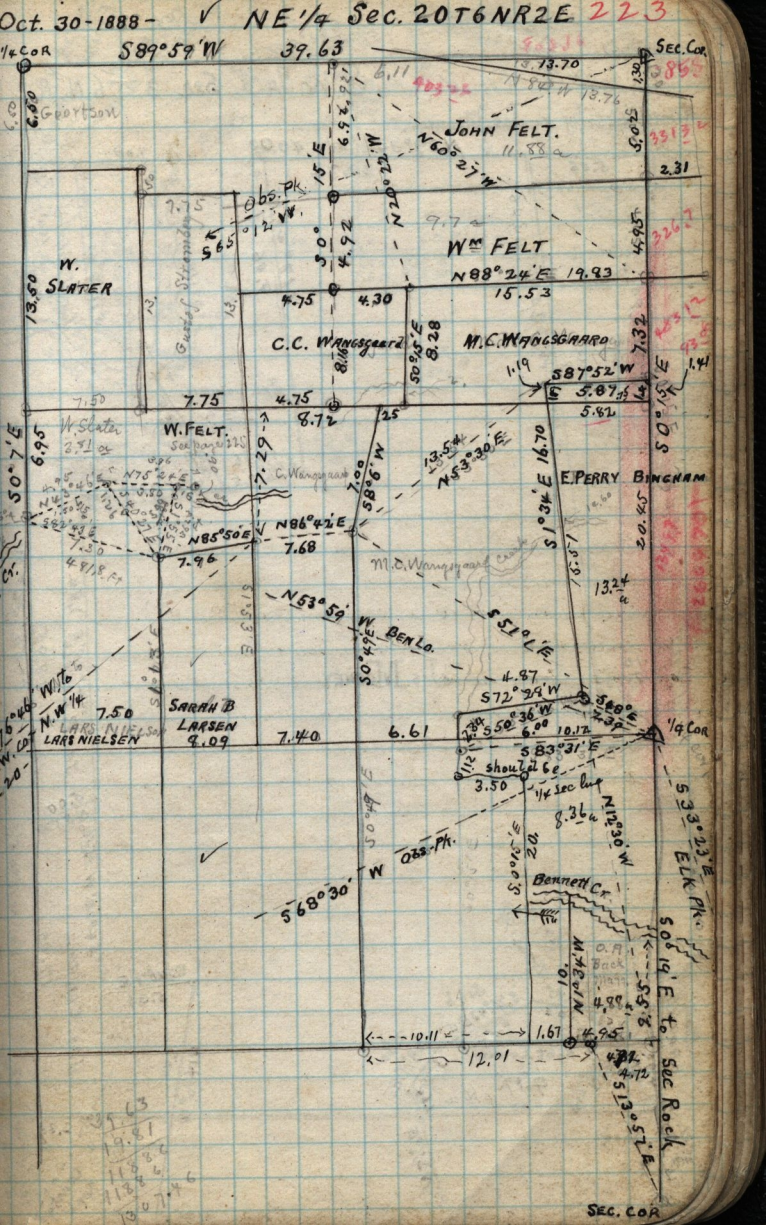Oct. 30-1888 - ✓ NE 1/4 Sec. 20 T6N R2E 223