224

S.W 1/4 Sec 3 T 6 N. R 2 W
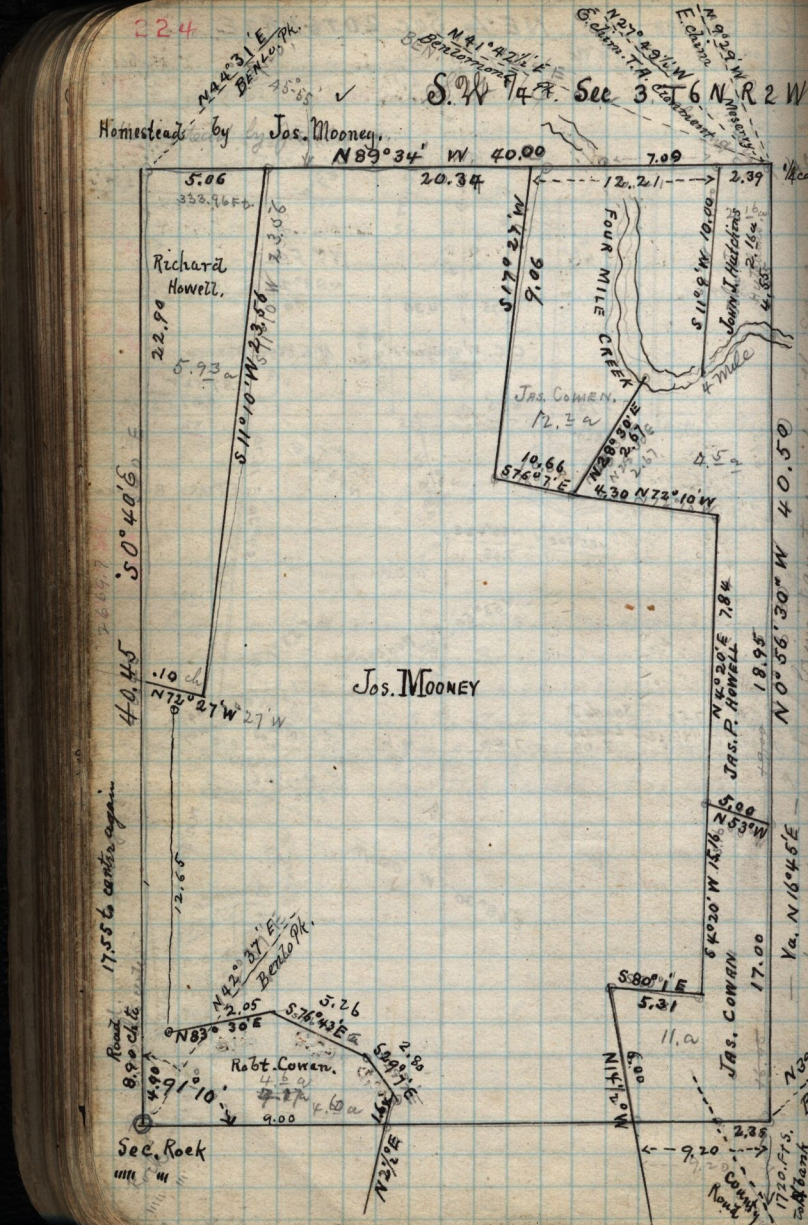
Homesteads by Jos. Mooney.