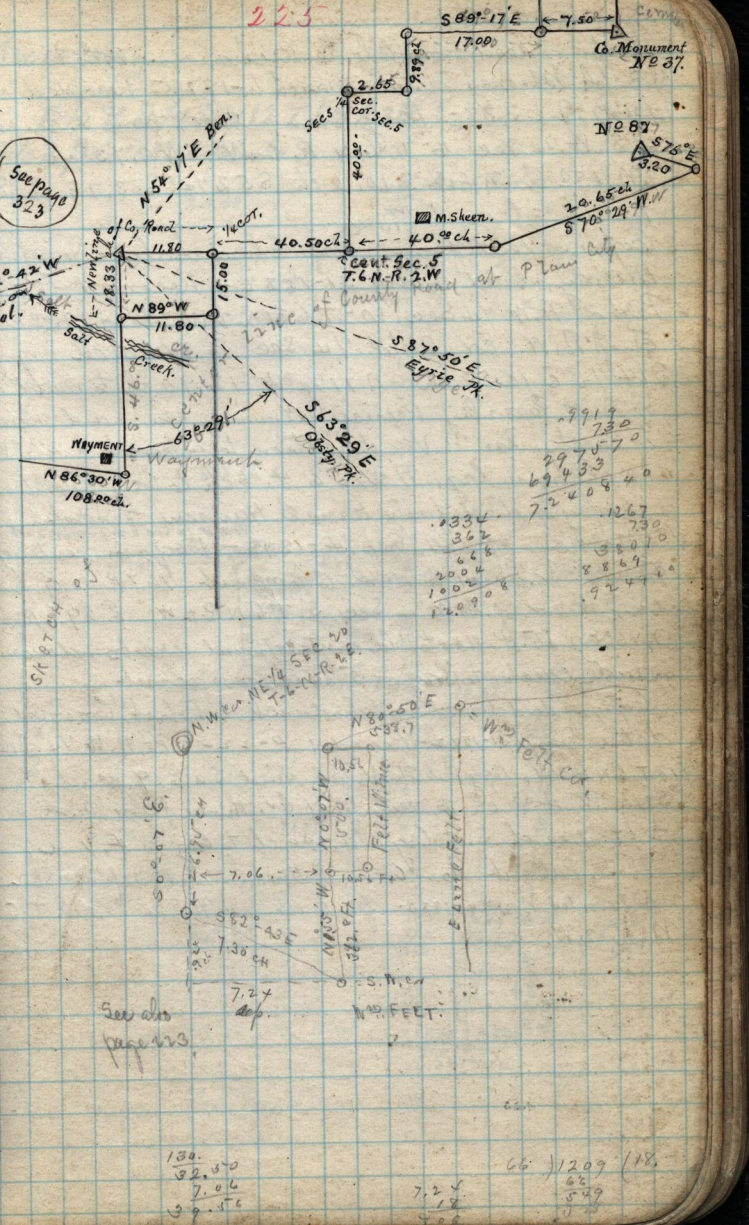
S 89°-17' E
7.50
17.00
9.89 ch
Co. Monument
No 37.
2.65
Sec 5
1/4 Sec. Cor. Sec. 5
40.00
No 87
S 75° E
3.20
See page 323
N 54° 17' E Bet.
of Co. Road
1/4 cor.
M. Skeen.
20.65 ch
S 70° 29' W
11.80
40.50 ch
40.00 ch
Cent. Sec. 5
T. 6 N. R. 2 W
Newline
18.33
15.00
N 89° W
11.80
Salt
Creek.
S 87° 50' E
Eyrie Pk.
S 63° 29' E
Obsty. Pk.
63° 29'
WAYMENT
N 86° 30' W
108.00 ch.
N.W. cor. NE 1/4 SEC 20
T-6-N-R-2-E
N 80° 50' E
538.7
10.56
Wm Felt Cor.
Felt Wine
7.06
10.56 Ft
S 82° 43' E
7.30 ch
7.24
dep.
S.W. cor
Wm. FELT.
See also page 223
130.
32.50
7.06
39.56
7.24
18
66) 1209 (18.
66
549