


236-

Nov. 26-1888

S.E. 1/4 Sec. 30 T6N R1W.

N. 89° 23' E

city Post.

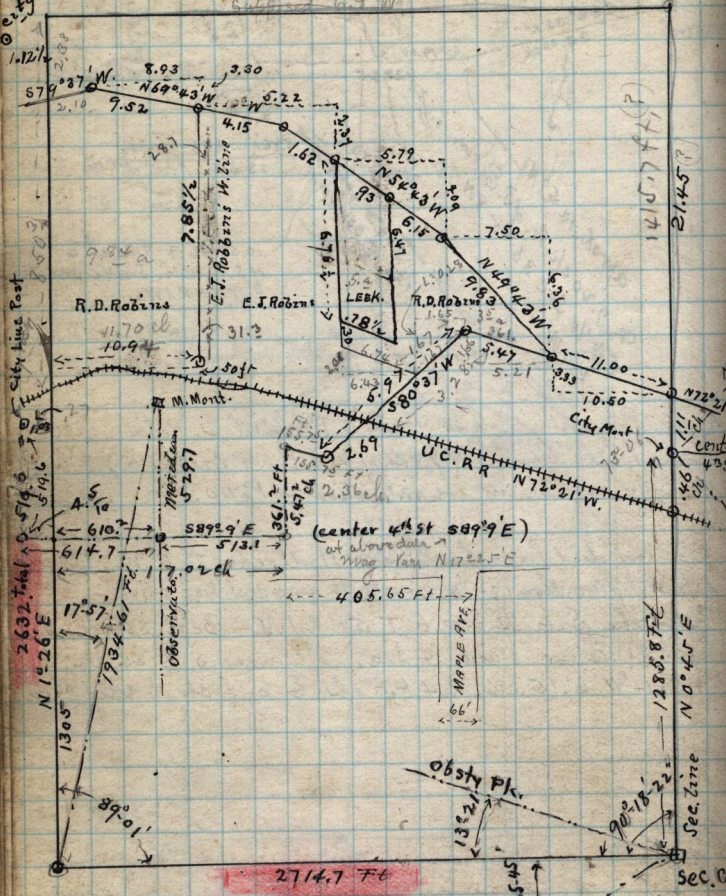

City Line Post

2632.1661

Deeds paid for. 10.00

2714.7 Ft

Obsty Pk.



