Dec. 13-1888 ✓ 245

Copy of U. S. Patent to George W. Ward Mayor of Willard City Box Elder County, dated Nov-20-1882- for- S. W 1/4 of S. E 1/4 Sec 23- and W 1/2 of N. E 1/4 Sec 26- T 8 N. R 2 W, containing 120. acres
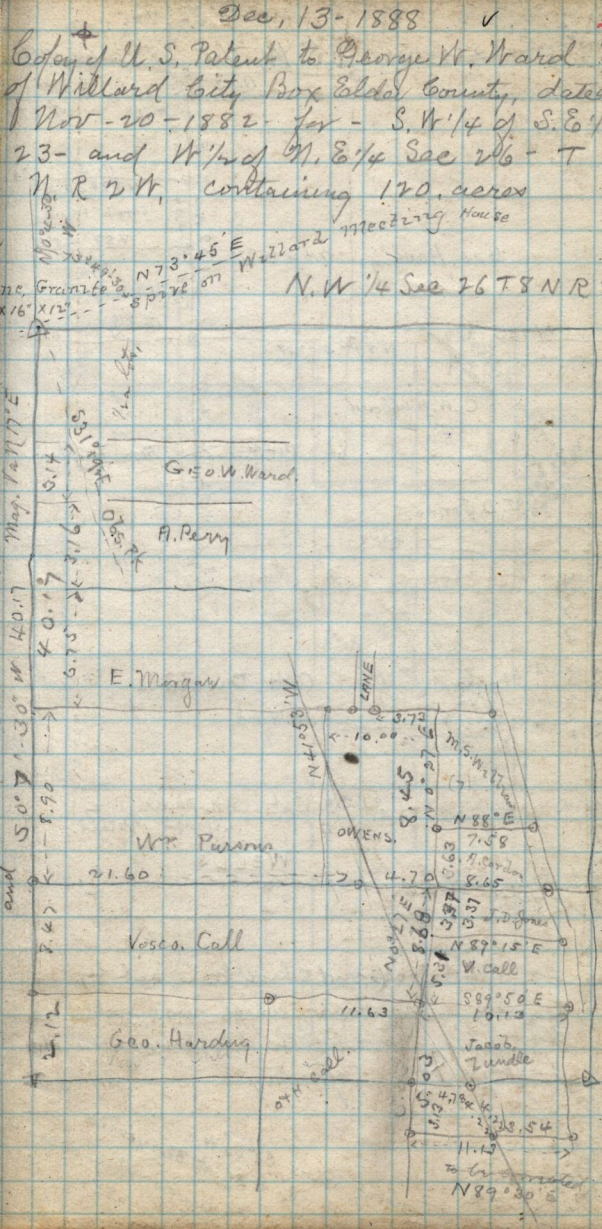
N.W 1/4 Sec 26 T 8 N R 2 W