246

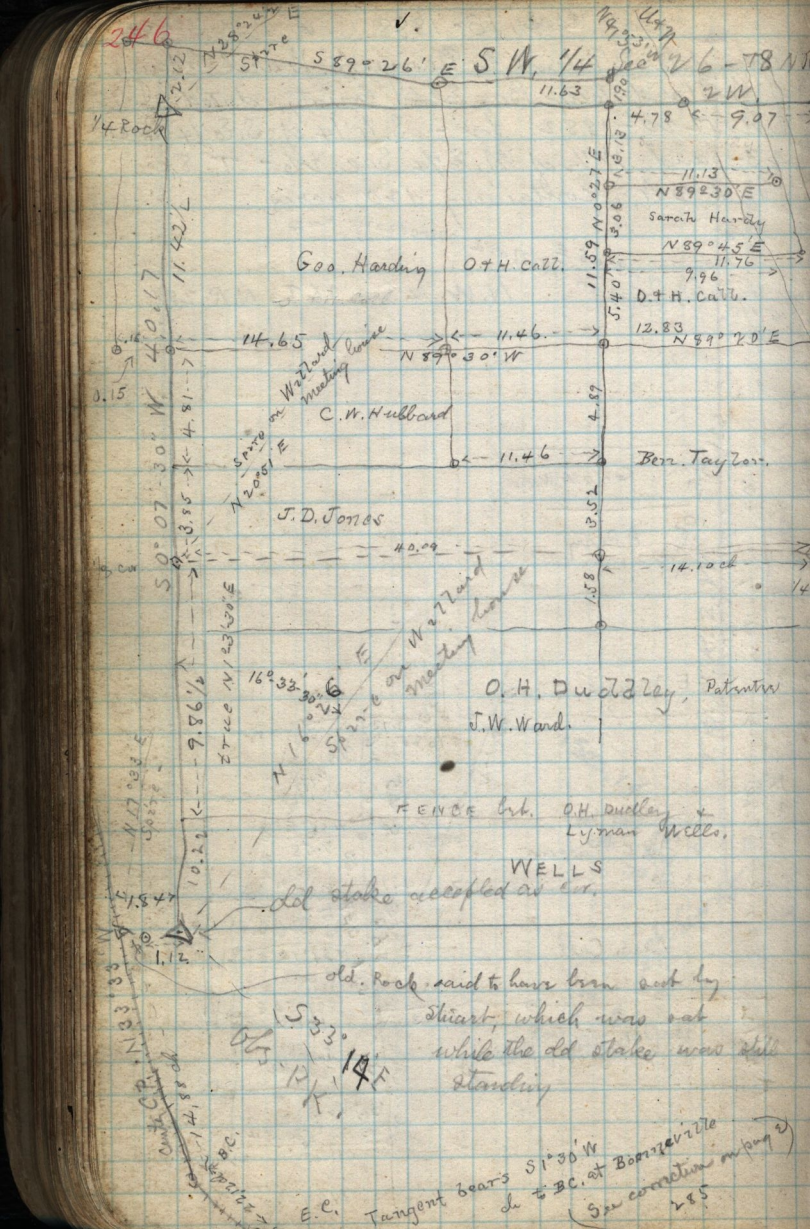
S 89° 26' E
S W 1/4
11.63
4.78
9.07
11.13
N 89° 30' E
Sarah Harding
N 89° 45' E
11.76
9.96
D. & H. Cattle.
12.83
N 89° 30' E
Geo. Harding
D. & H. Cattle.
14.65
11.46
N 89° 30' W
C. W. Hubbard
Bert. Taylor.
J. D. Jones
40.09
14.10
O. H. Dudley, Patentee
J. W. Wards
FENCE bet. O.H. Dudley & Lyman Wells.
WELLS
old stake accepted as cor.
old Rock said to have been set by Stuart, which was set while the old stake was still standing
S 33°
E.C. Tangent bears S 1° 30' W
to B.C. at Bonneville
(See correction on page 2)
185