Dec. 13-1888. — PLAT - of WILLARD 247
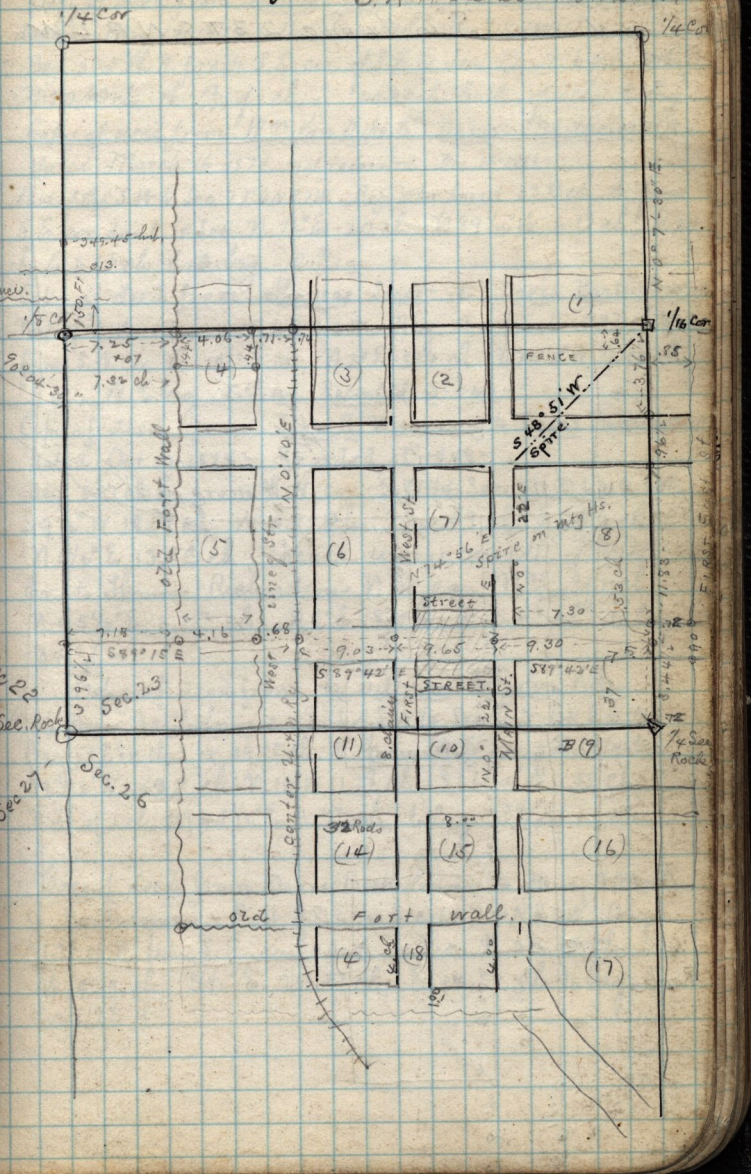
✓ S.W. 1/4 Sec 23 - T 8 N R 3 W.