Dec. 19-20-1888
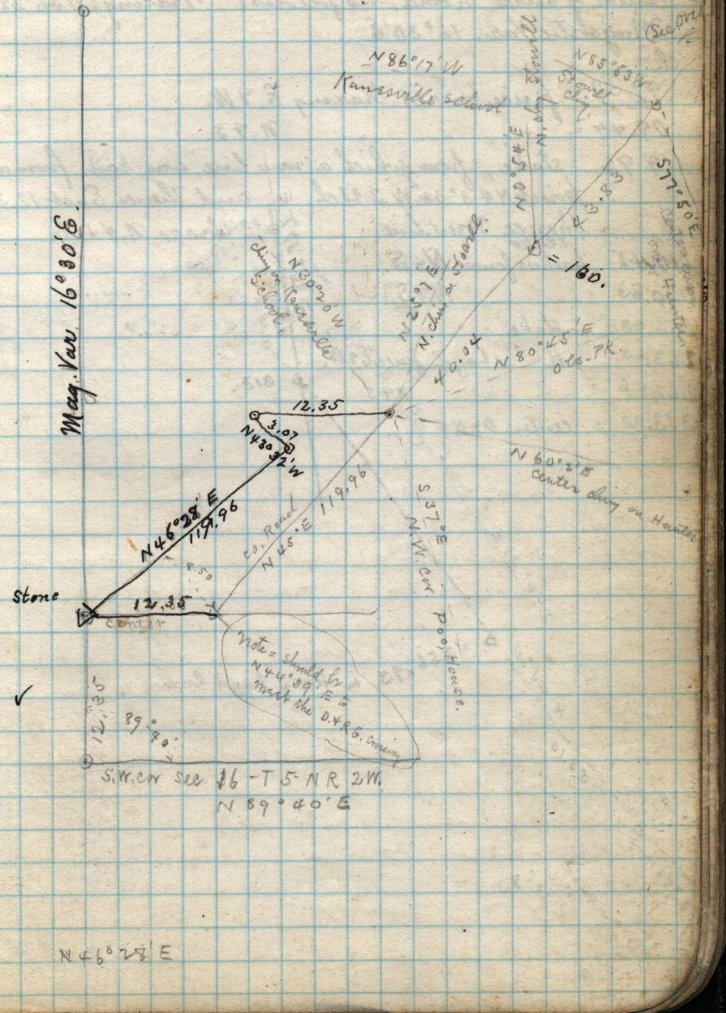
Location of County Road in Hooper, J. Wallace and W. W. Child Selectmen, David A. Jenkins and Alfred Manny Chairman