252 — Dec- 20- 1888 —

Notes of County Road leading N. E. from a point 40. chains East from North West line in Hooper, or at a point 12.35 chains N. from S.W. cor Sec 16 T 5 N R 2 W, where a red sandstone monument 4"x4"x18" was place to marker the center of said Road, as follows: Bearing: N 46° 28' E. Magnetic Var. 16° 30' E.

Ch:

97.50 = fence, (wire) bearing E. & W.

109.49 = " " N. & S.

119.96 stake, from which a new line, was ran, from a point N 43° 32' W 3.01 ch, and thence East 12.35 Thence N. & W. line bears N. 45° E.

160 stake

210.45 Lashus fence. N. & S.

230.83 " " N. & S,

256.93 stake

263.23 H Loyd fence E. & W.

267.46 " " N. & S
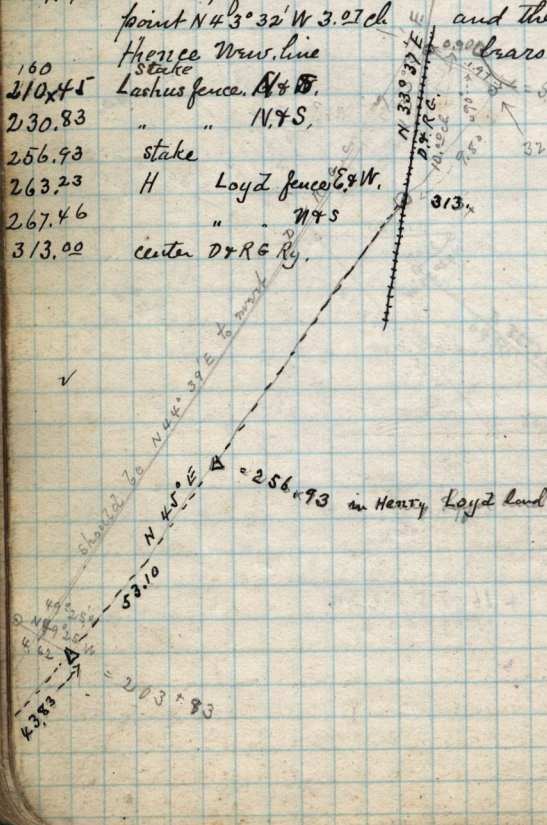
313.00 center D. & R. G. Ry.