


Dec. 26-1888- Survey of County
Road at Hooper

✓

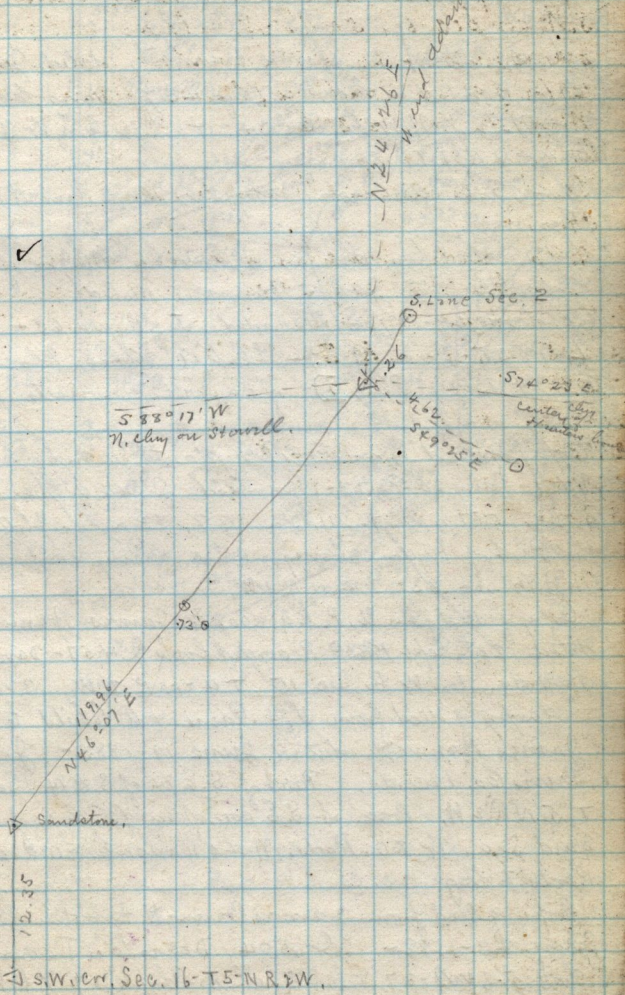

See also page 268 -