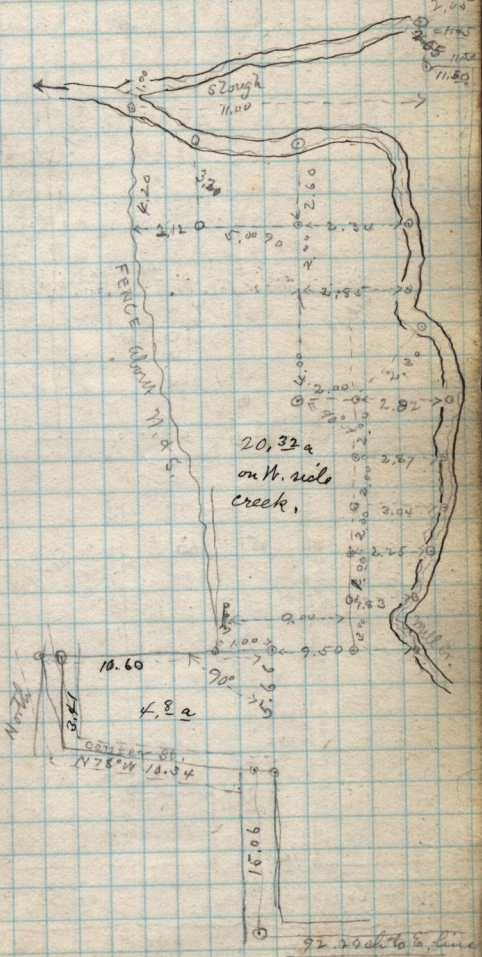
Slough
11.00
FENCE about N. & S.
20.32 a
on W. side
creek.
10.60
4.8 a
North
center St.
N 78° W 10.34
15.06
Mill Cr.
92.29 ch to E. line
Sec. 13 T. 8 N R2
W.